


2 SECOND FLOOR
3/16" = 1'-0"

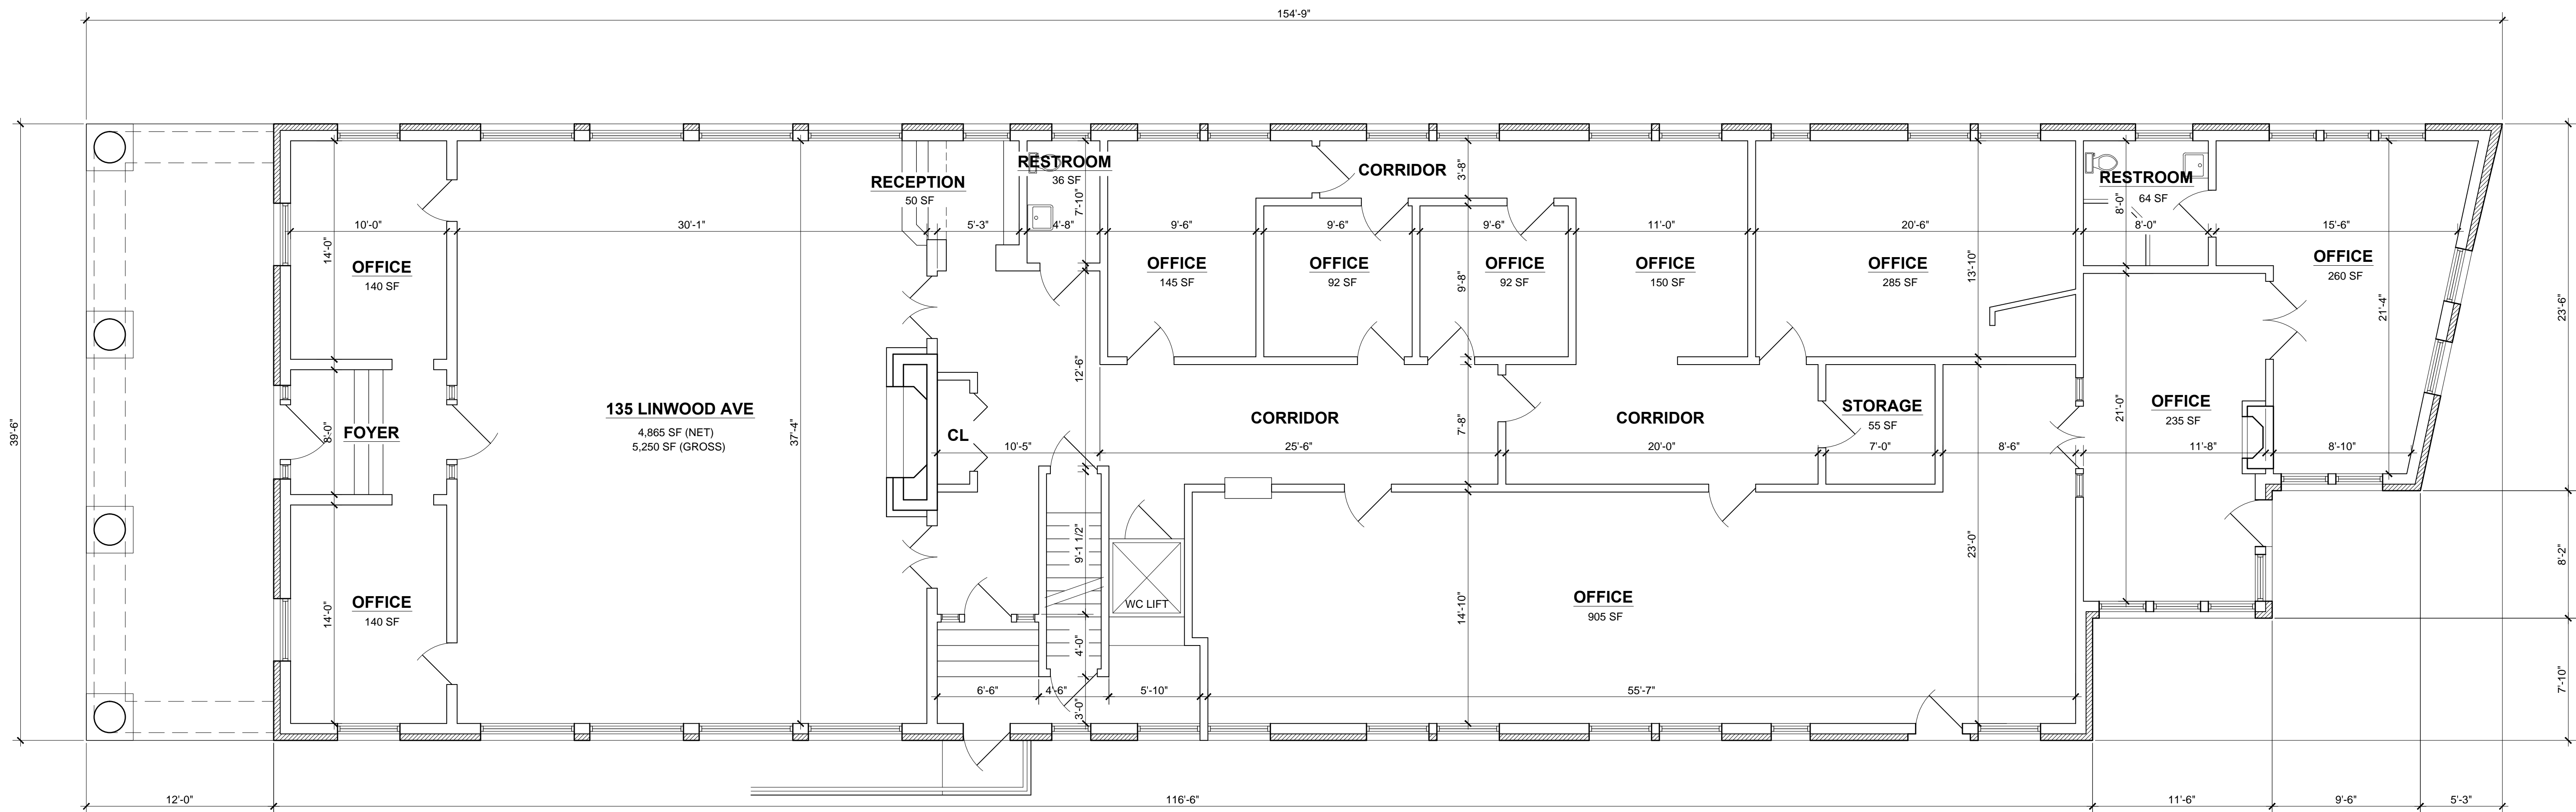


1 FIRST FLOOR
3/16" = 1'-0"

DR. WILLIAM CAPICOTTO MD.

135 LINWOOD AVE.
BUFFALO, N.Y.

design ■ renovations ■ interiors

CONWAY
&
COMPANY
ARCHITECTS

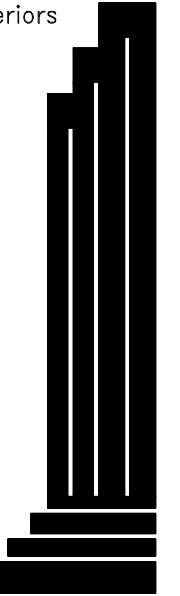

2320 WEHRLE DRIVE
WILLIAMSVILLE, NY
14221
PH. 631-1160 FAX 631-1128

No

© 2017 CONWAY AND COMPANY ARCHITECTS
This drawing may not be reproduced, copied, altered or otherwise used without the written consent of the Architect.

Drawings conveyed for acquisition of building permit shall be signed, sealed and dated.

Revisions / Submissions Date

RECORD DRAWING

Issue Date 12-4-17

Sheet Title

FLOOR PLANS

Drawn by: JW

Checked by:

Scale: AS NOTED

Project No.:

Drawing No.

A2